

Managed and Leased by:

**ARI-EL**


Ari-El Enterprises, Inc.  
(248) 557-3800  
www.ari-el.com

**CARSON OFFICE CENTER**  
**29425 Northwestern Highway**  
Southfield, Michigan

Suite 330  
Approx. 573 Rentable Square Feet

10.1.2009

AS BUILT

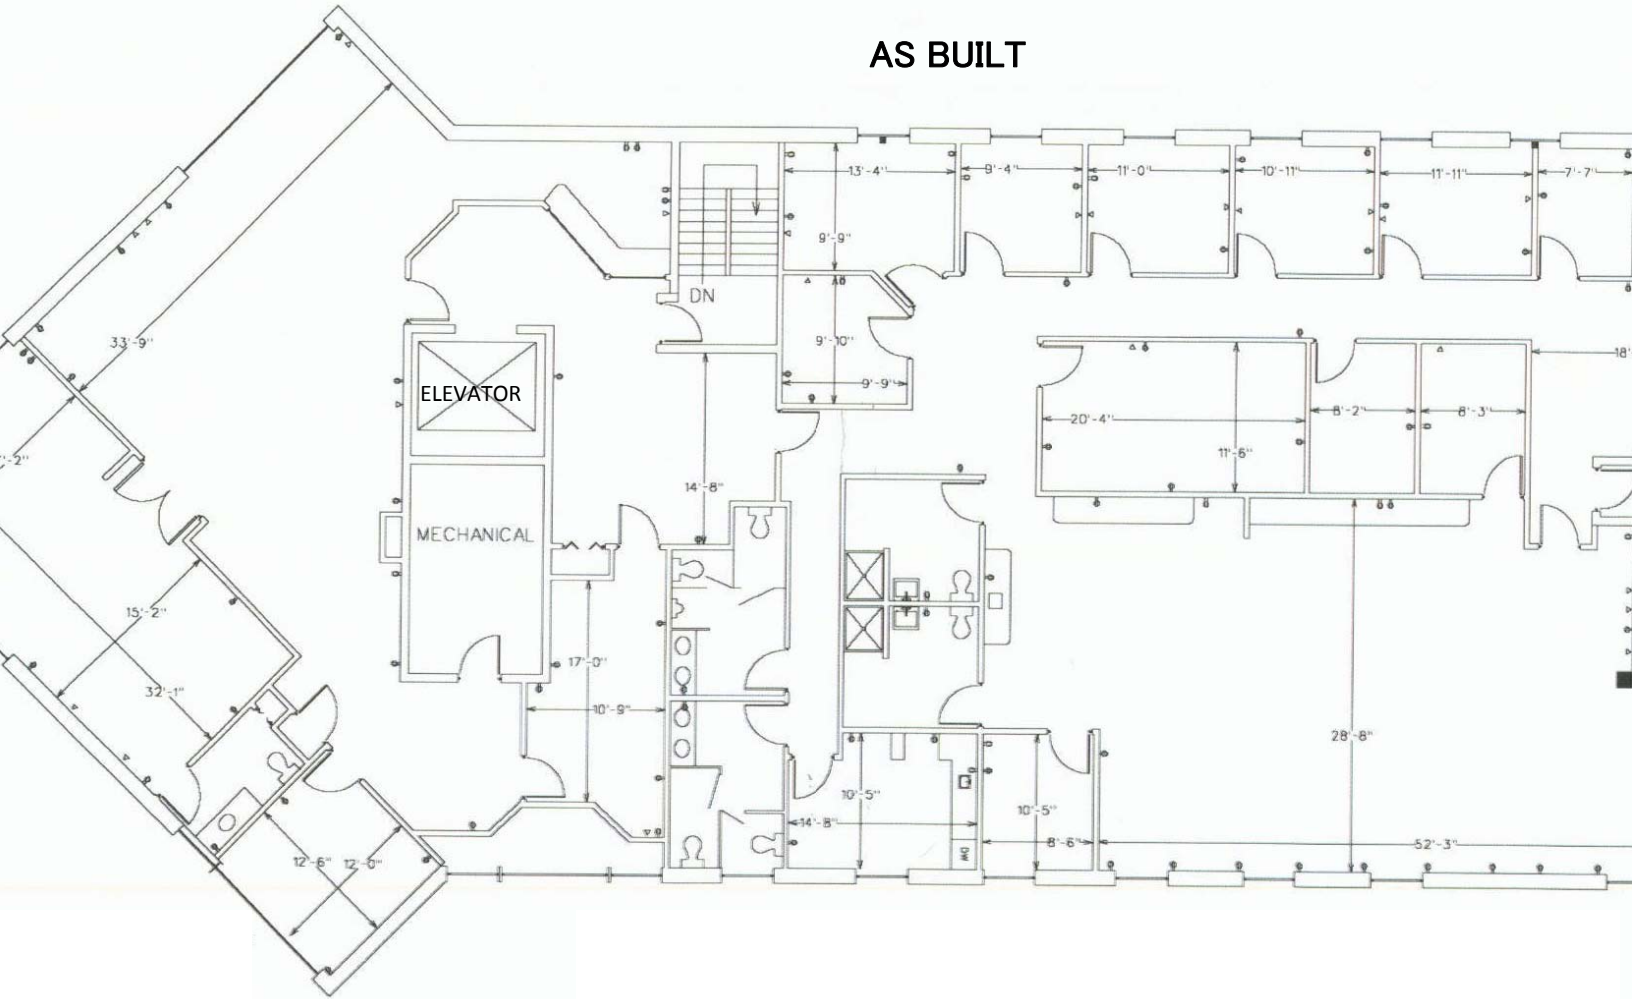

Owned and Leased by:



Enterprise, Inc.  
557-3800  
ari-el.com

**CARSON OFFICE CENTER**  
29425 Northwestern Highway  
Southfield, Michigan

Upper Level